




DESIGN B WILLIAMS	DRAWN BY B WILLIAMS	DART AEROSPACE LTD VICTORIA INTERNATIONAL AIRPORT, CANADA	
CHECKED BW	APPROVED [Signature]	DRAWING NO. D2365	REV. C SHEET 1 OF 1
DATE 95:01:20	TITLE WEAR PLATE		SCALE 2:1
C	95:03:06	0.191 WAS 0.197	

RELEASED
97/04/22 DS

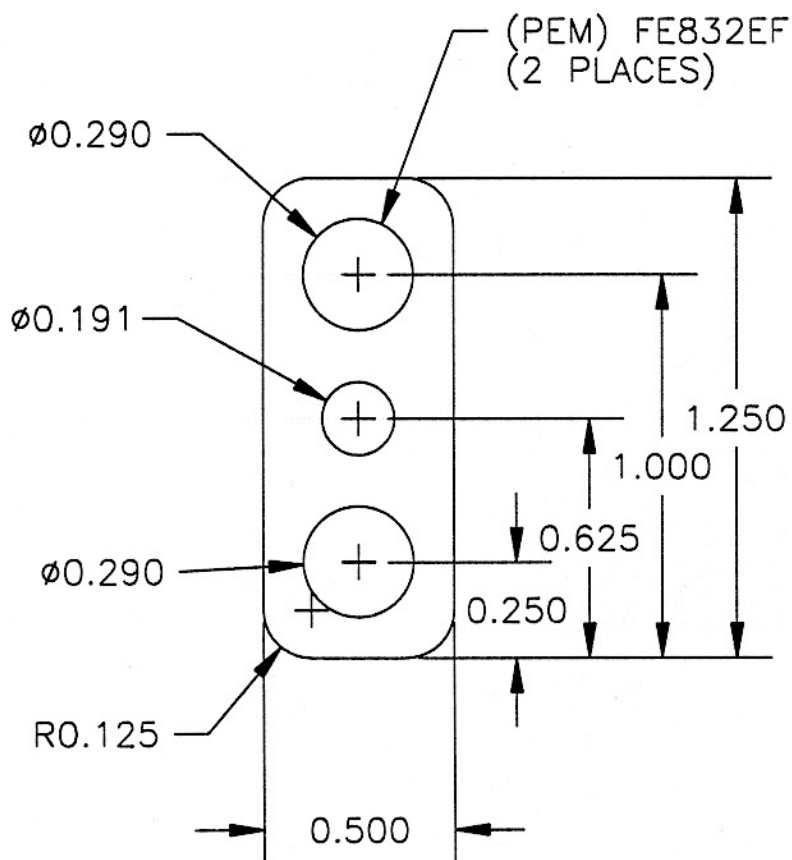

6061-T6 (00-A-250/11) 0.063 THICK } # 00.09.26
ACID ETCH & ALODINE PER QSI 005 4.1-1 } #
INSTALL FE832EF (2 PLS) AFTER ALODINE } # 00.03.07
MATERIAL: ~~6061-T6 ALUMINUM 0.063 THICK, ANODIZE BLACK~~
~~AFTER ANODIZING INSTALL (PEM FE832EF) 2 PLACES~~